



FIRST FLOOR LEVEL

SCALE 1/8" = 1'-0"

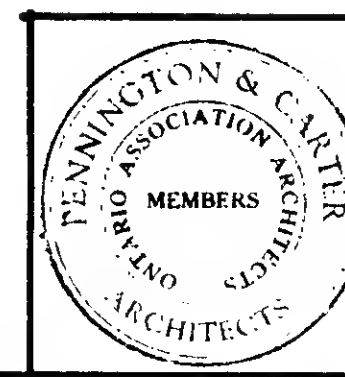


LIBRARY BUILDING
FOR
ASSUMPTION UNIVERSITY OF WINNIPEG
PENNINGTON & CARTER ARCHITECTS
WINNIPEG, MANITOBA

101-2
1152
SHEET NO.
3
DATE
MAY 1957

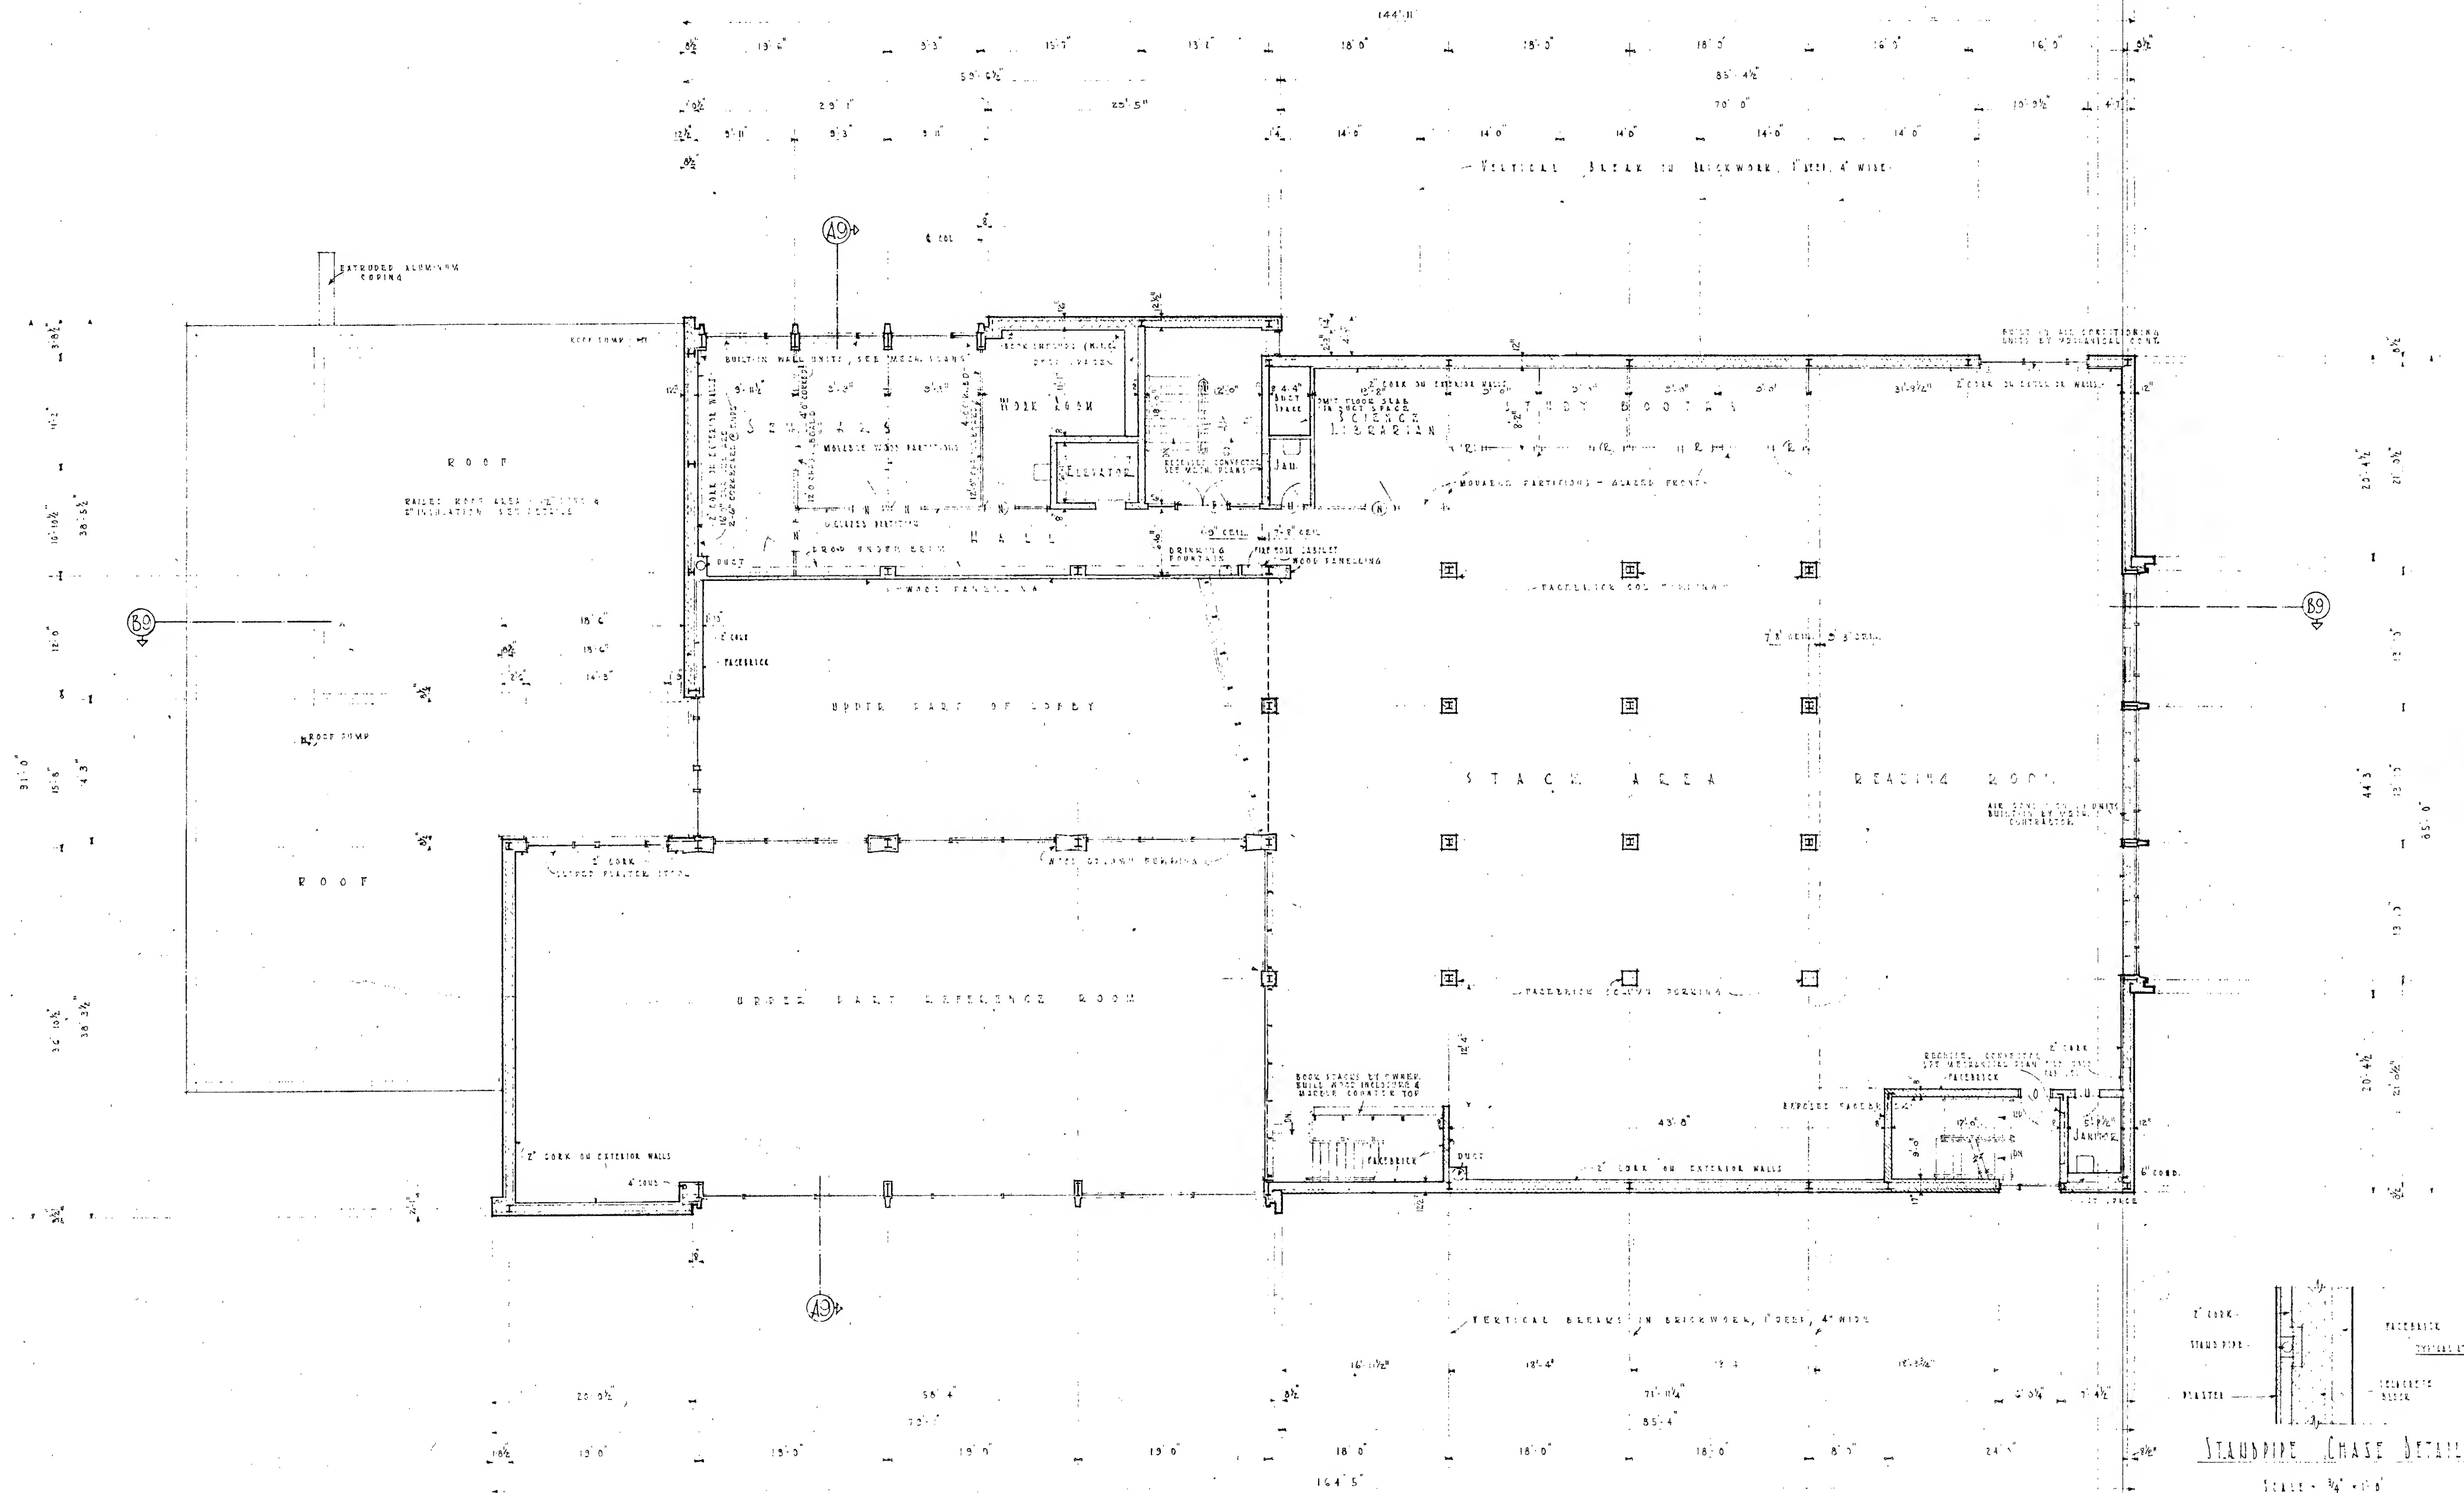


SECOND (MEZZANINE) LEVEL PLAN

SCALE = 3/8" = 1'-0"

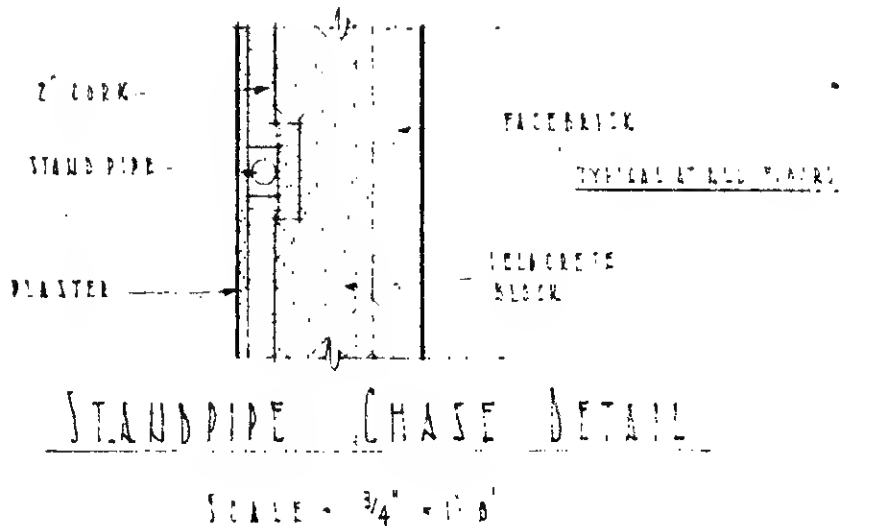


	LIBRARY BUILDING		368 1152
	FOR ASSUMPTION UNIVERSITY OF WINDSOR		SHEET NO. 4
	PENNINGTON & CARTER, ARCHITECTS		DATE: MAY 15, 1957
	WINDSOR, ONTARIO		

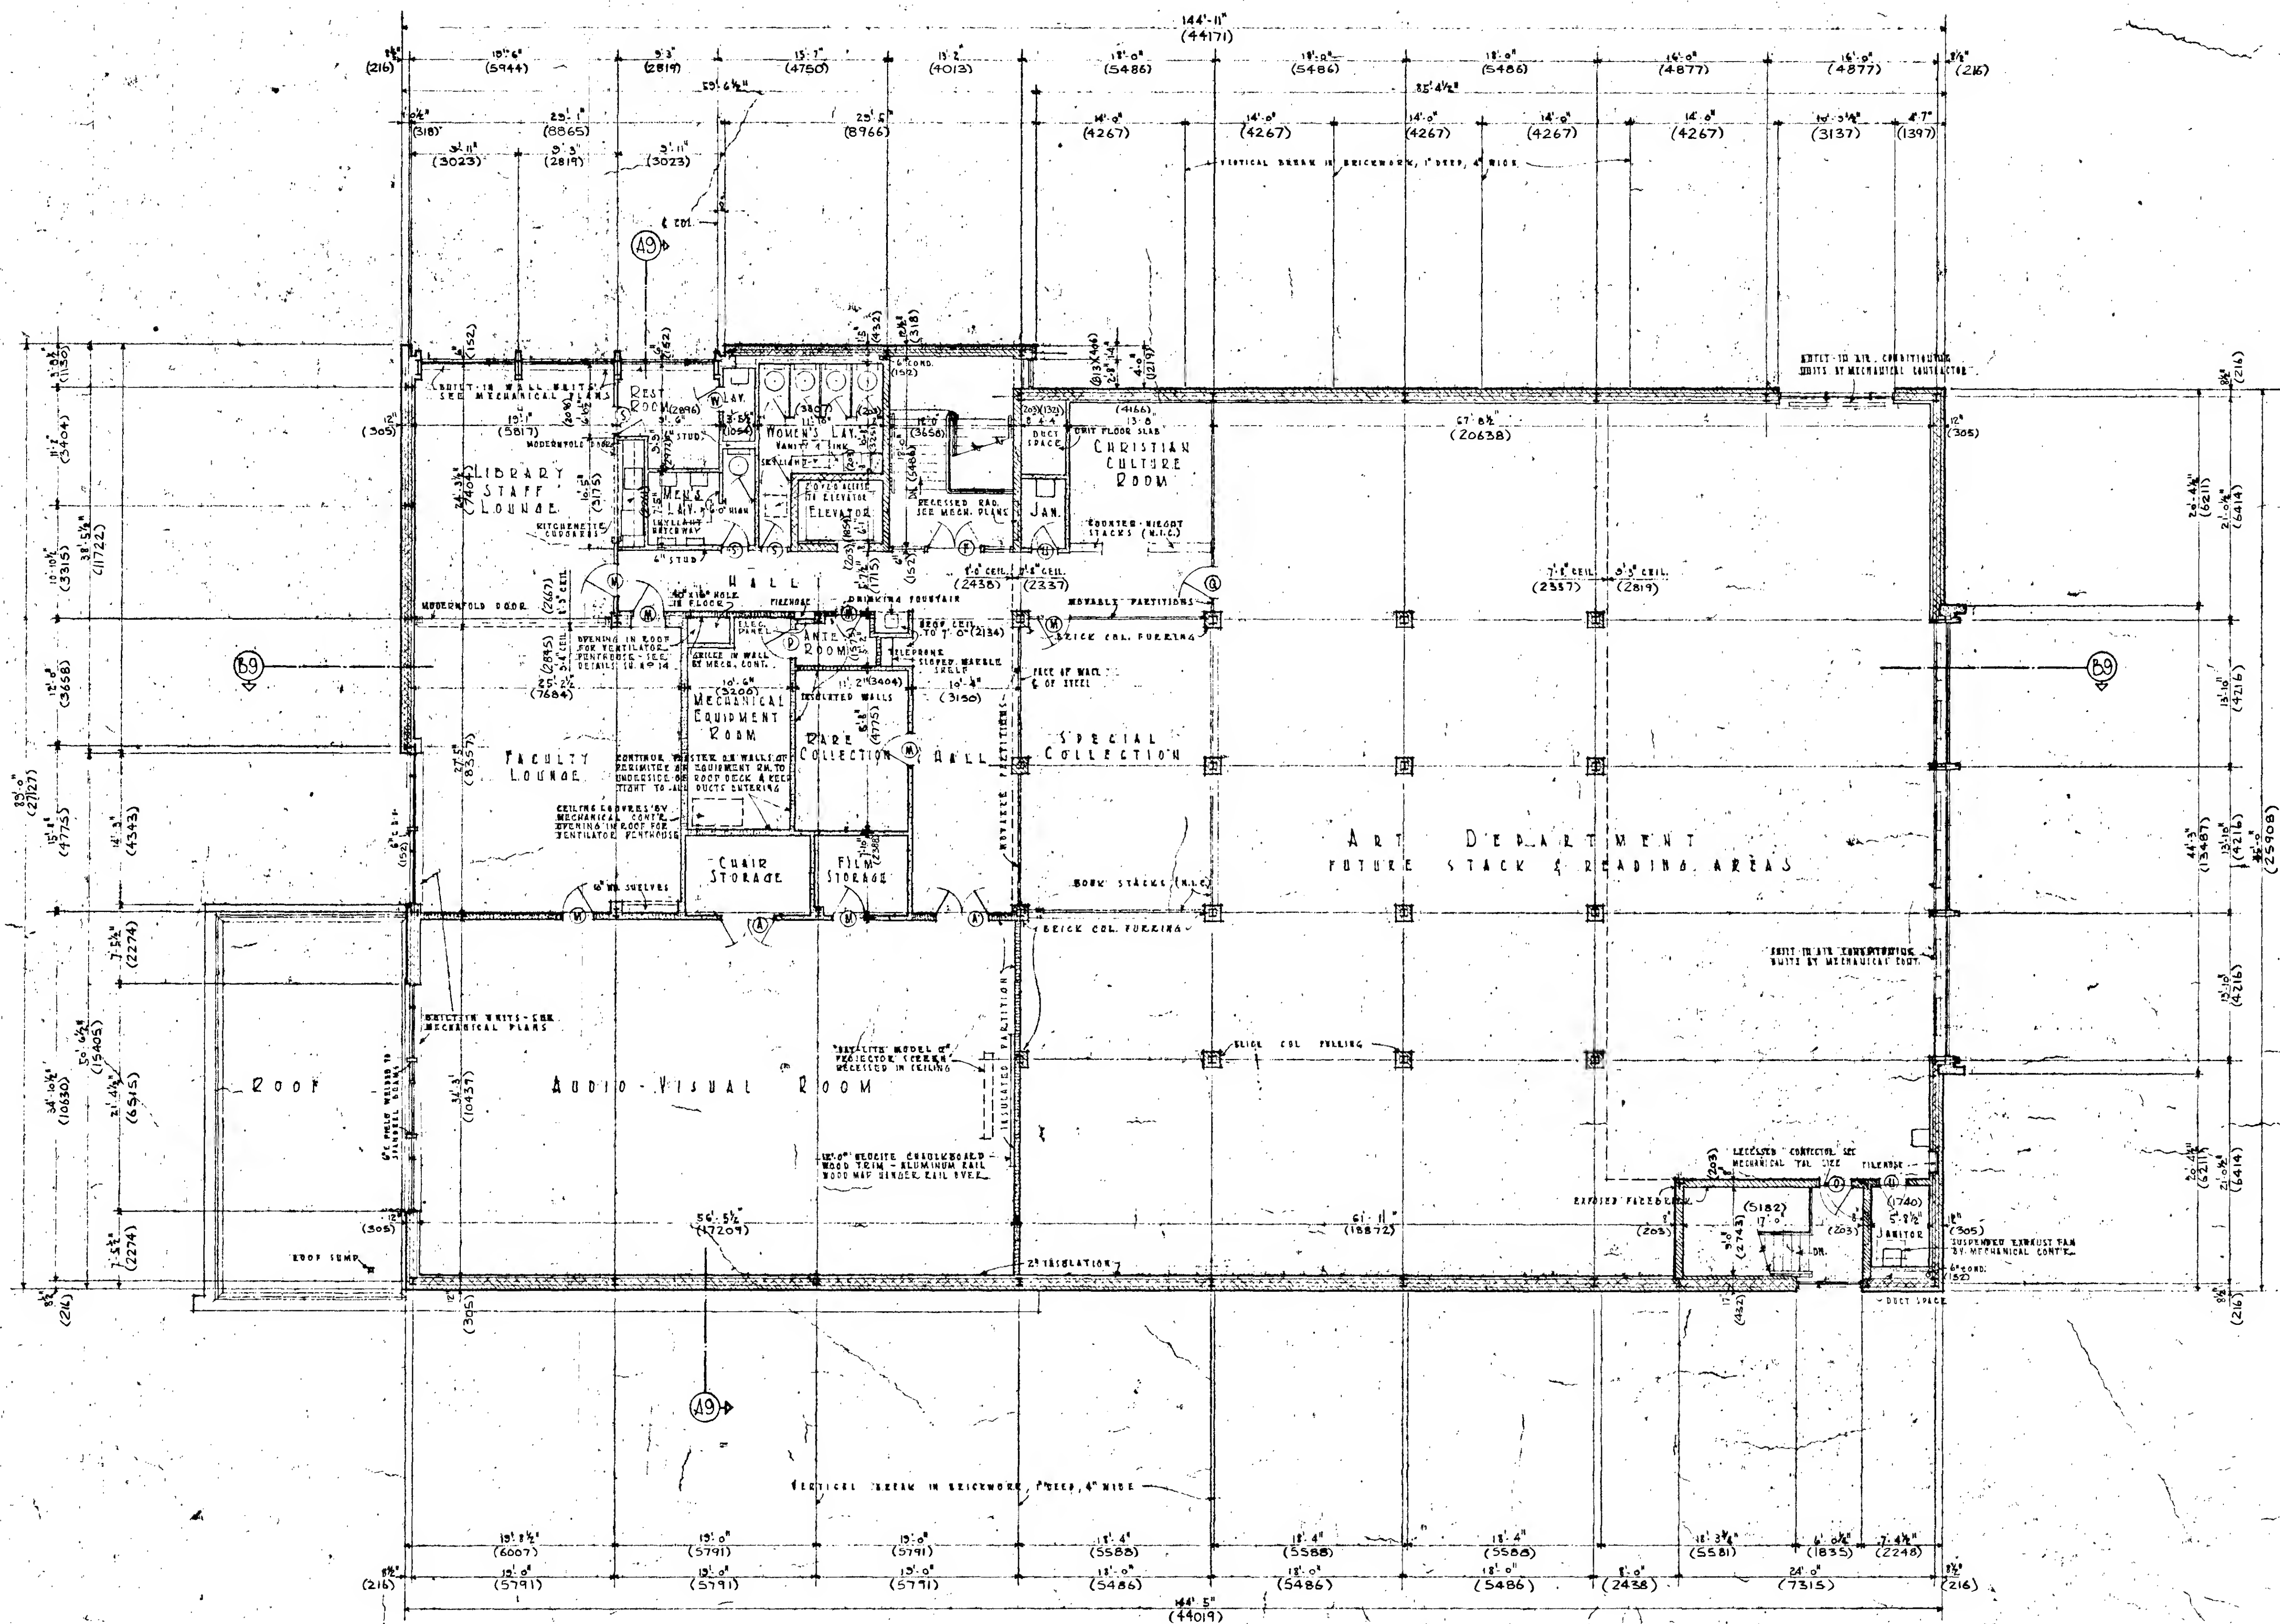


THIRD LEVEL PLAN

SCALE: 1/8" = 1'-0"

"METRIC" MEASUREMENTS SHOWN IN PARENTHESES ARE IN MILLIMETRES AND ARE EQUIVALENT TO IMPERIAL MEASUREMENTS SHOWN

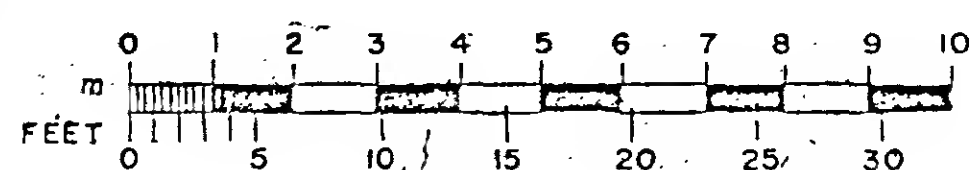

AS BUILT & METRIC CONVERSIONS MAR. 31, 83 L.R.K.

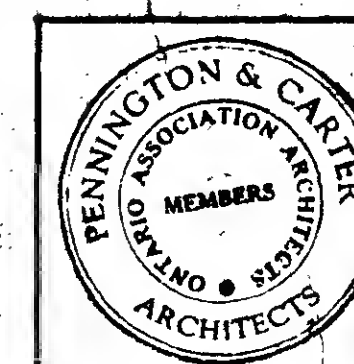


LIBRARY BUILDING
FOR
ASSUMPTION UNIVERSITY / WINNIPEG

PENNINGTON & CARTER ARCHITECTS
MORRIS BUILDING WINNIPEG, ONTARIO

JOB NO.
1152

SHEET NO.
5


DATE
MAY 18/57

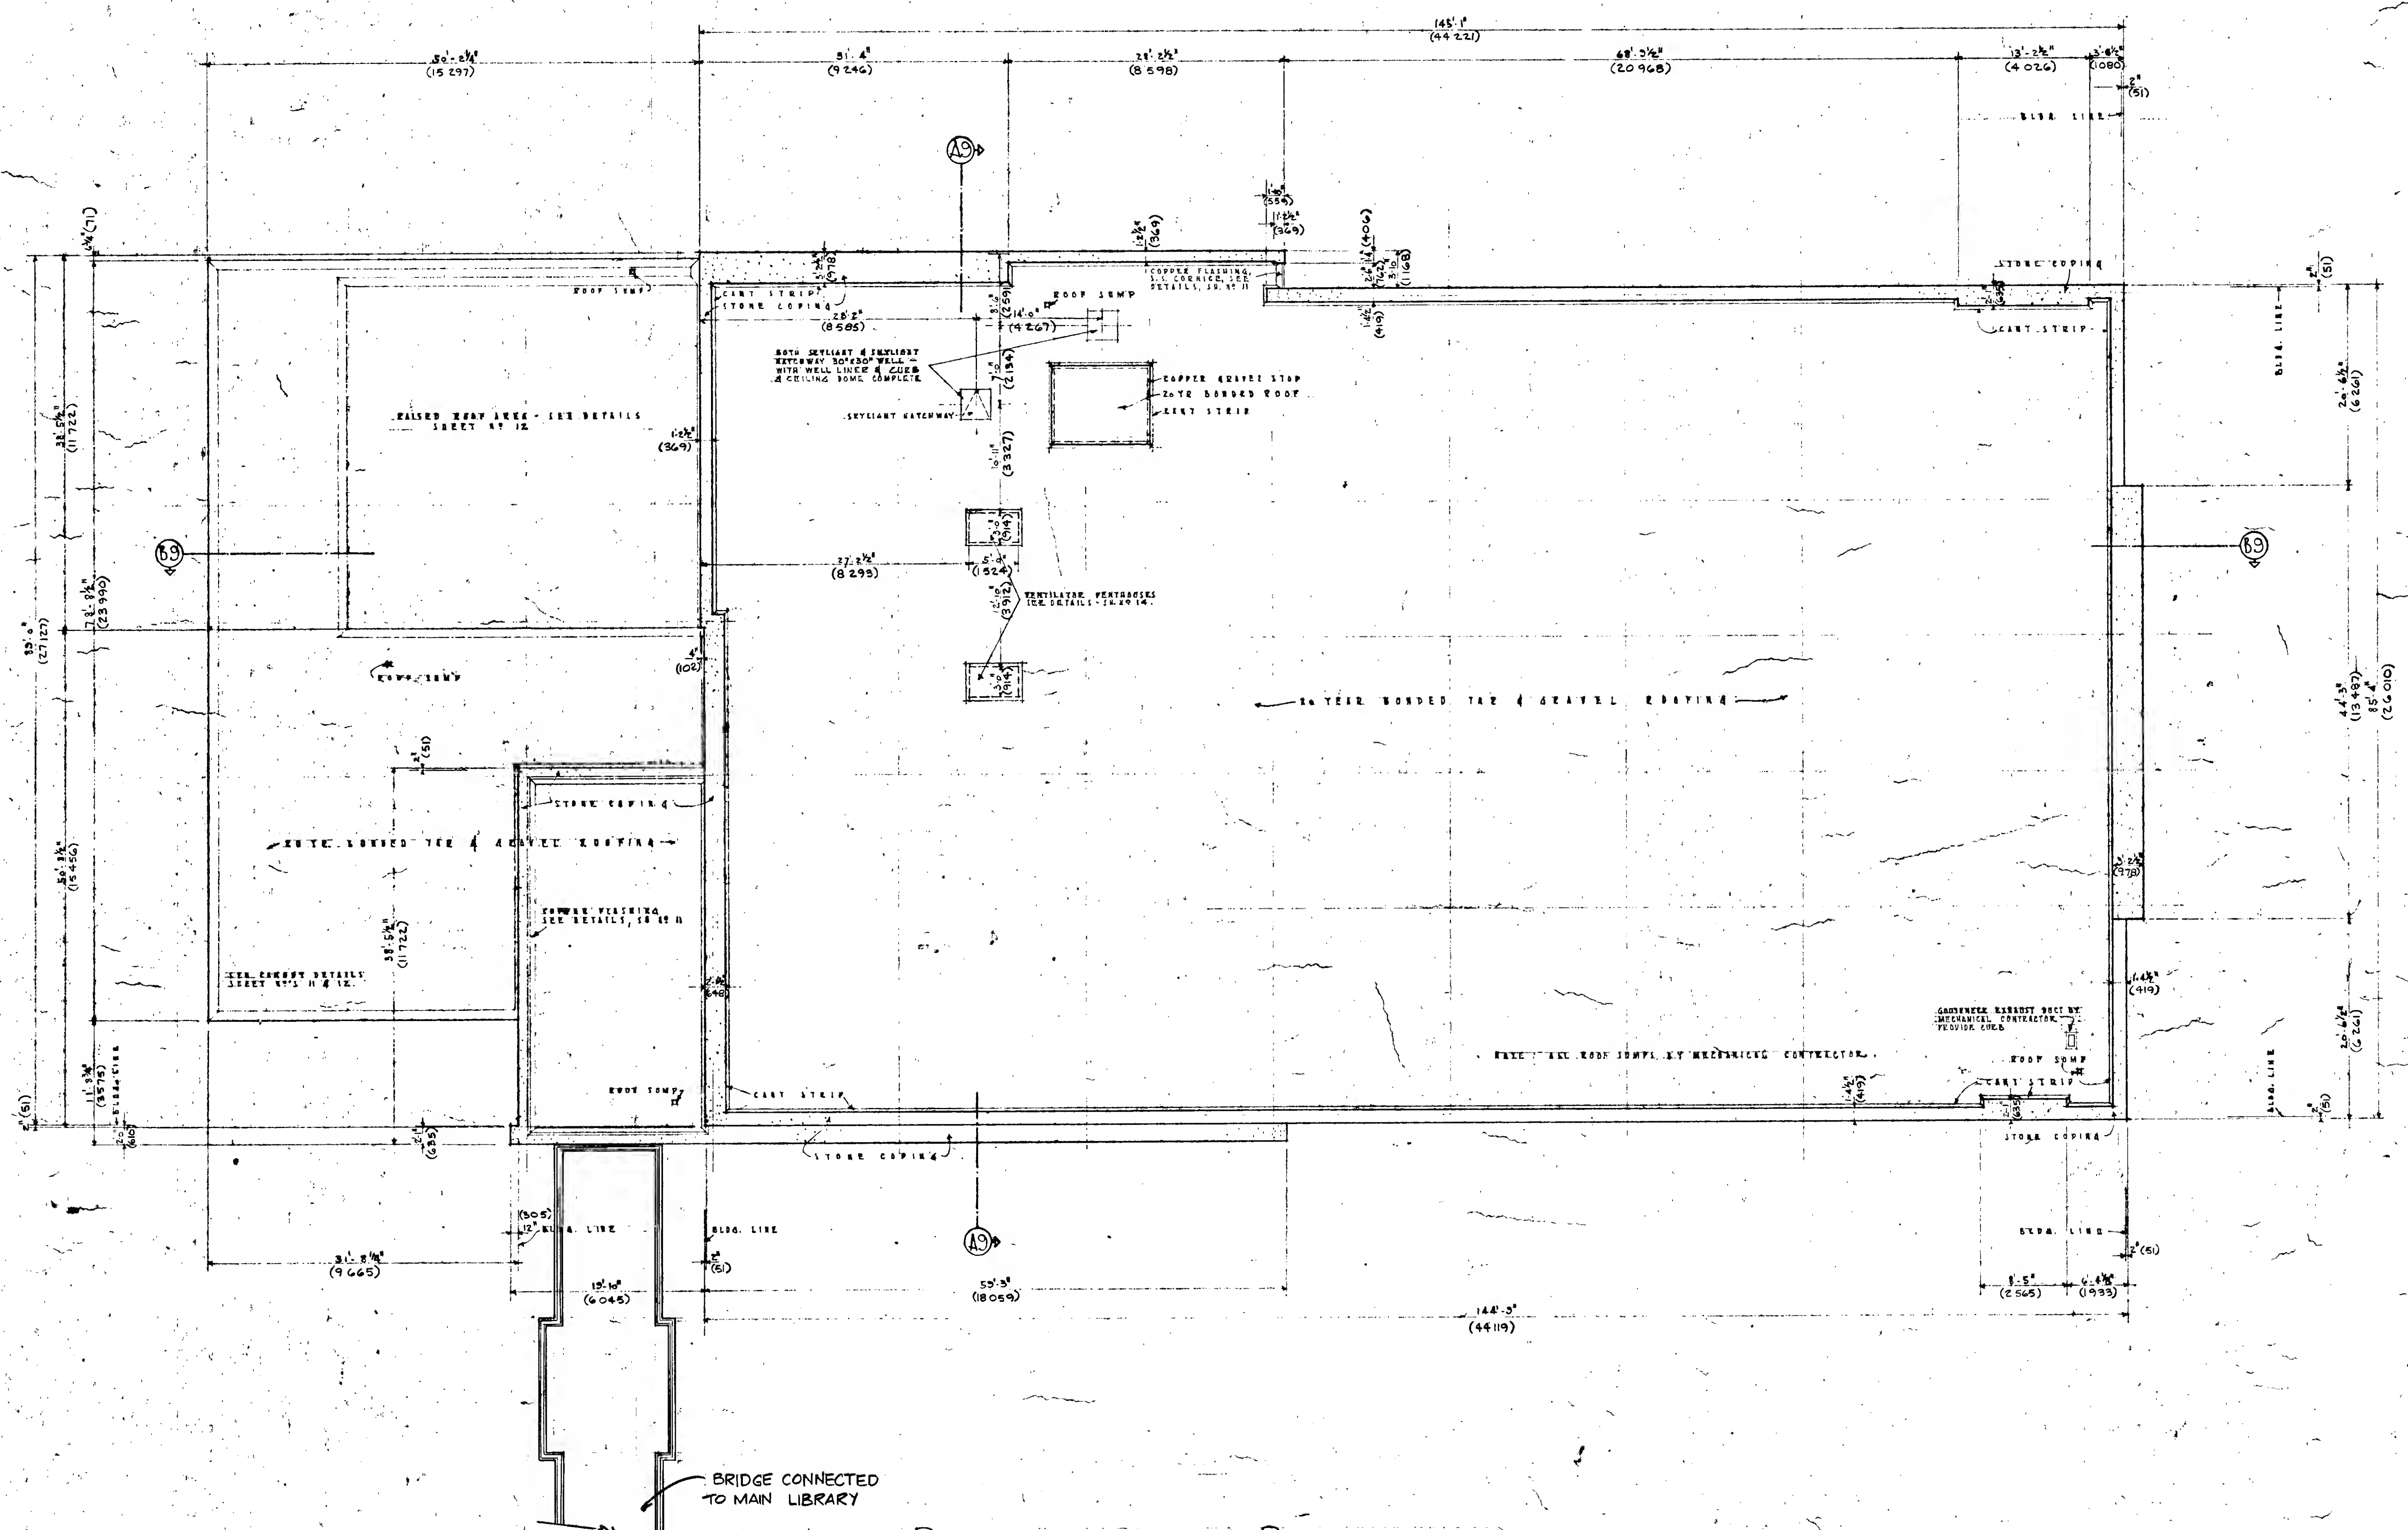


ROOF PLAN

SCALE 1/8" = 1'-0"


"METRIC" MEASUREMENTS SHOWN IN PARENTHESIS ARE IN MILLIMETRES AND ARE EQUIVALENT TO IMPERIAL MEASUREMENTS SHOWN

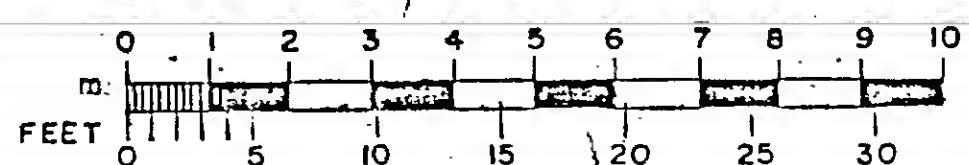

DATE	REVISIONS
MARCH 1953	AS BUILT & METRIC CONVERSIONS

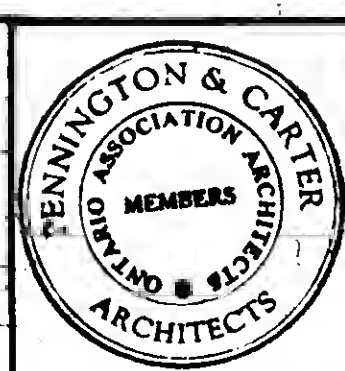


LIBRARY BUILDING		JOB NO. 1152
FOR ASSUMPTION UNIVERSITY OF WINSTON		SHEET NO. 6
PENNINGTON & CARTER	ARCHITECTS	DATE MAY 18/57
MOBILE BUILDING	WINSTON DUTELLE	

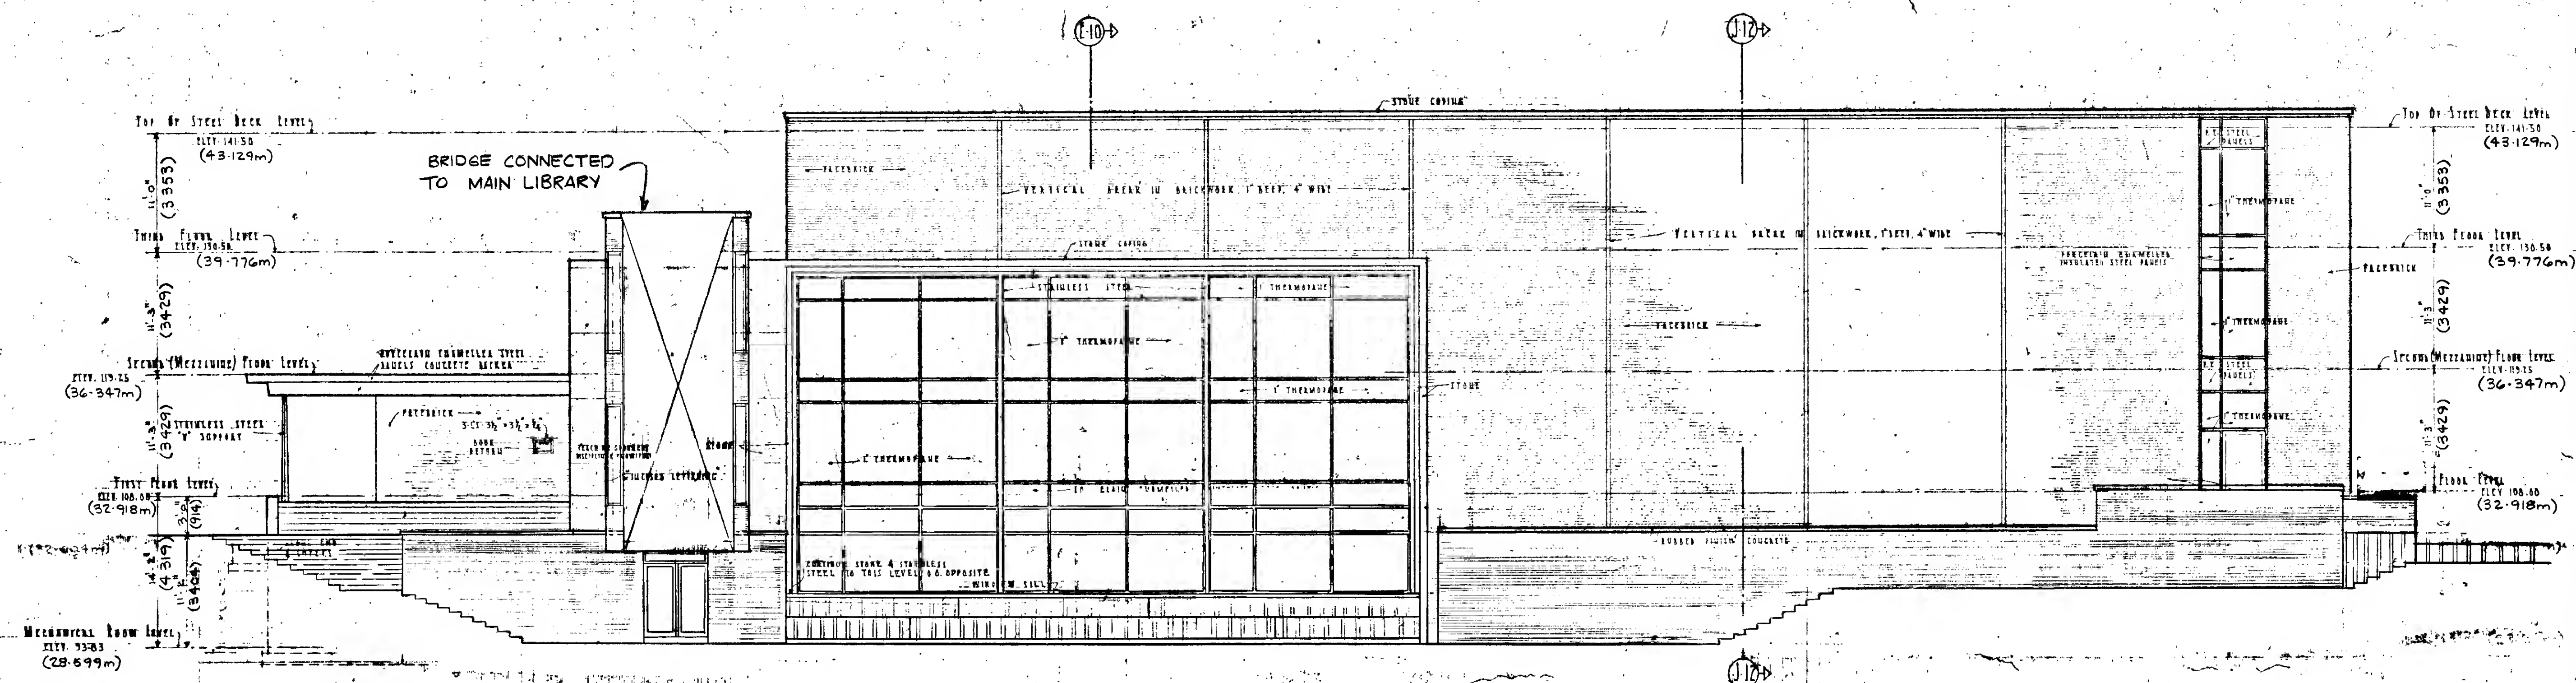

EAST ELEVATION


SCALE: 1/8" = 1'-0"

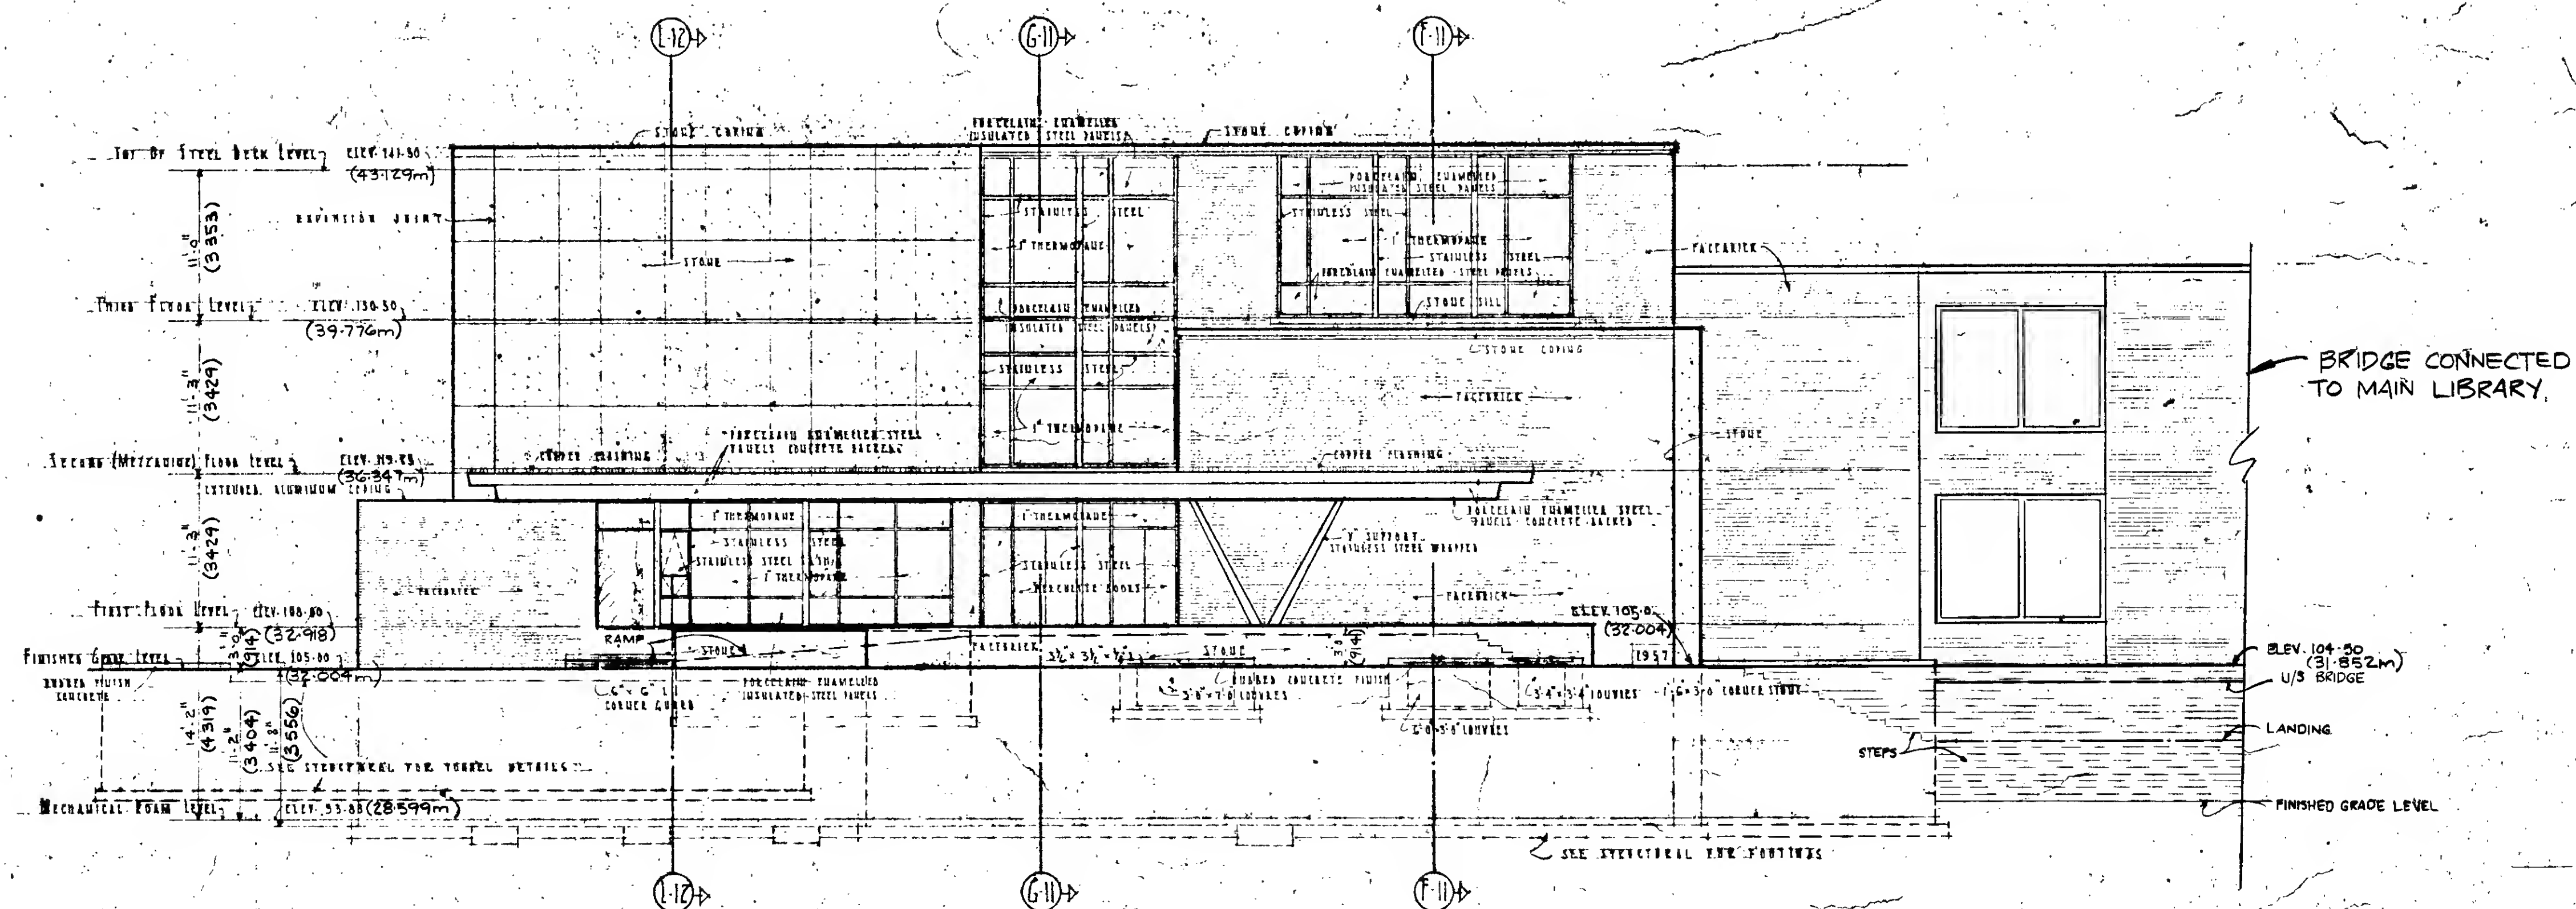


SOUTH ELEVATION

SCALE: 1/8" = 1'-0"

"METRIC" MEASUREMENTS SHOWN IN PARENTHESIS
ARE IN MILLIMETRES AND ARE EQUIVALENT
TO IMPERIAL MEASUREMENTS SHOWN


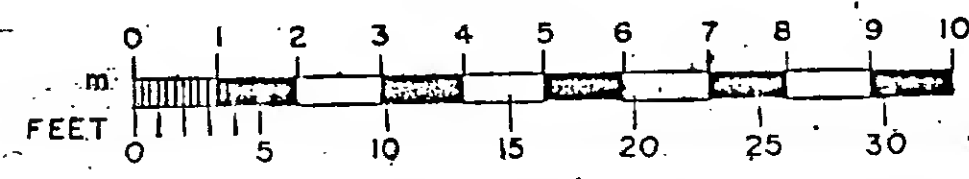


DATE	REVISIONS
MARCH 1972	AS BUILT & METRIC CONVERSIONS

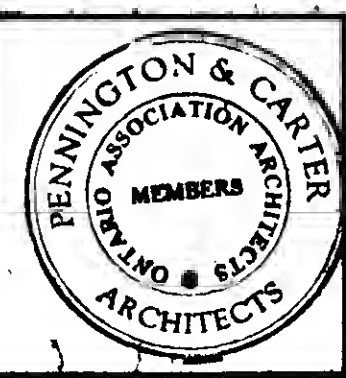


LIBRARY BUILDING
FOR
ASSUMPTION UNIVERSITY WINNIPEG
PENNINGTON & CARTER, ARCHITECTS
WINNIPEG, MANITOBA, CANADA


JOB NO.
1152
SHEET NO.
7
DATE
MAY 18/57

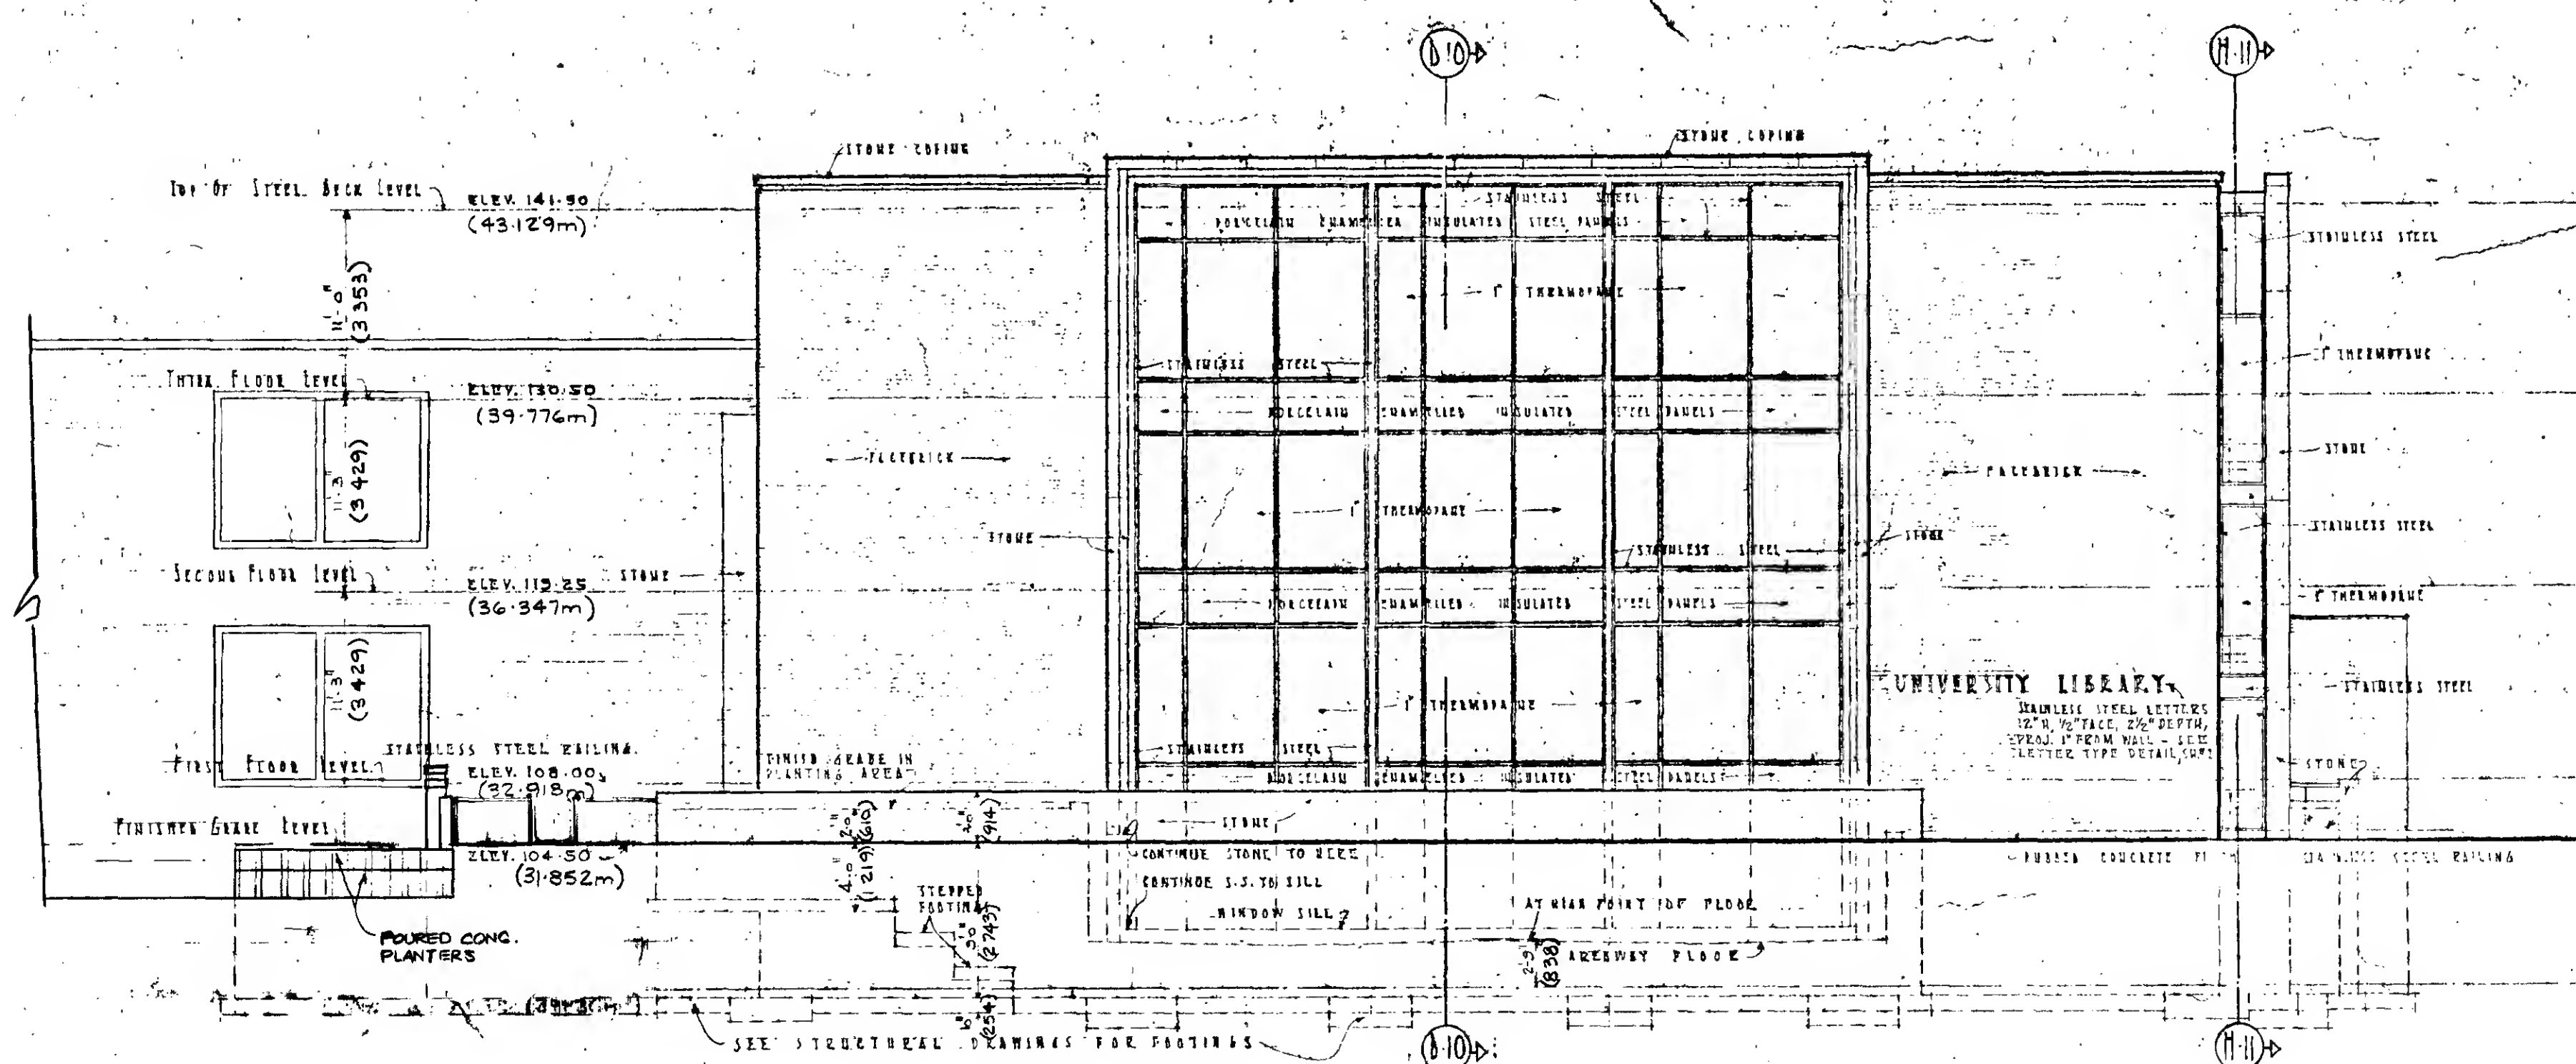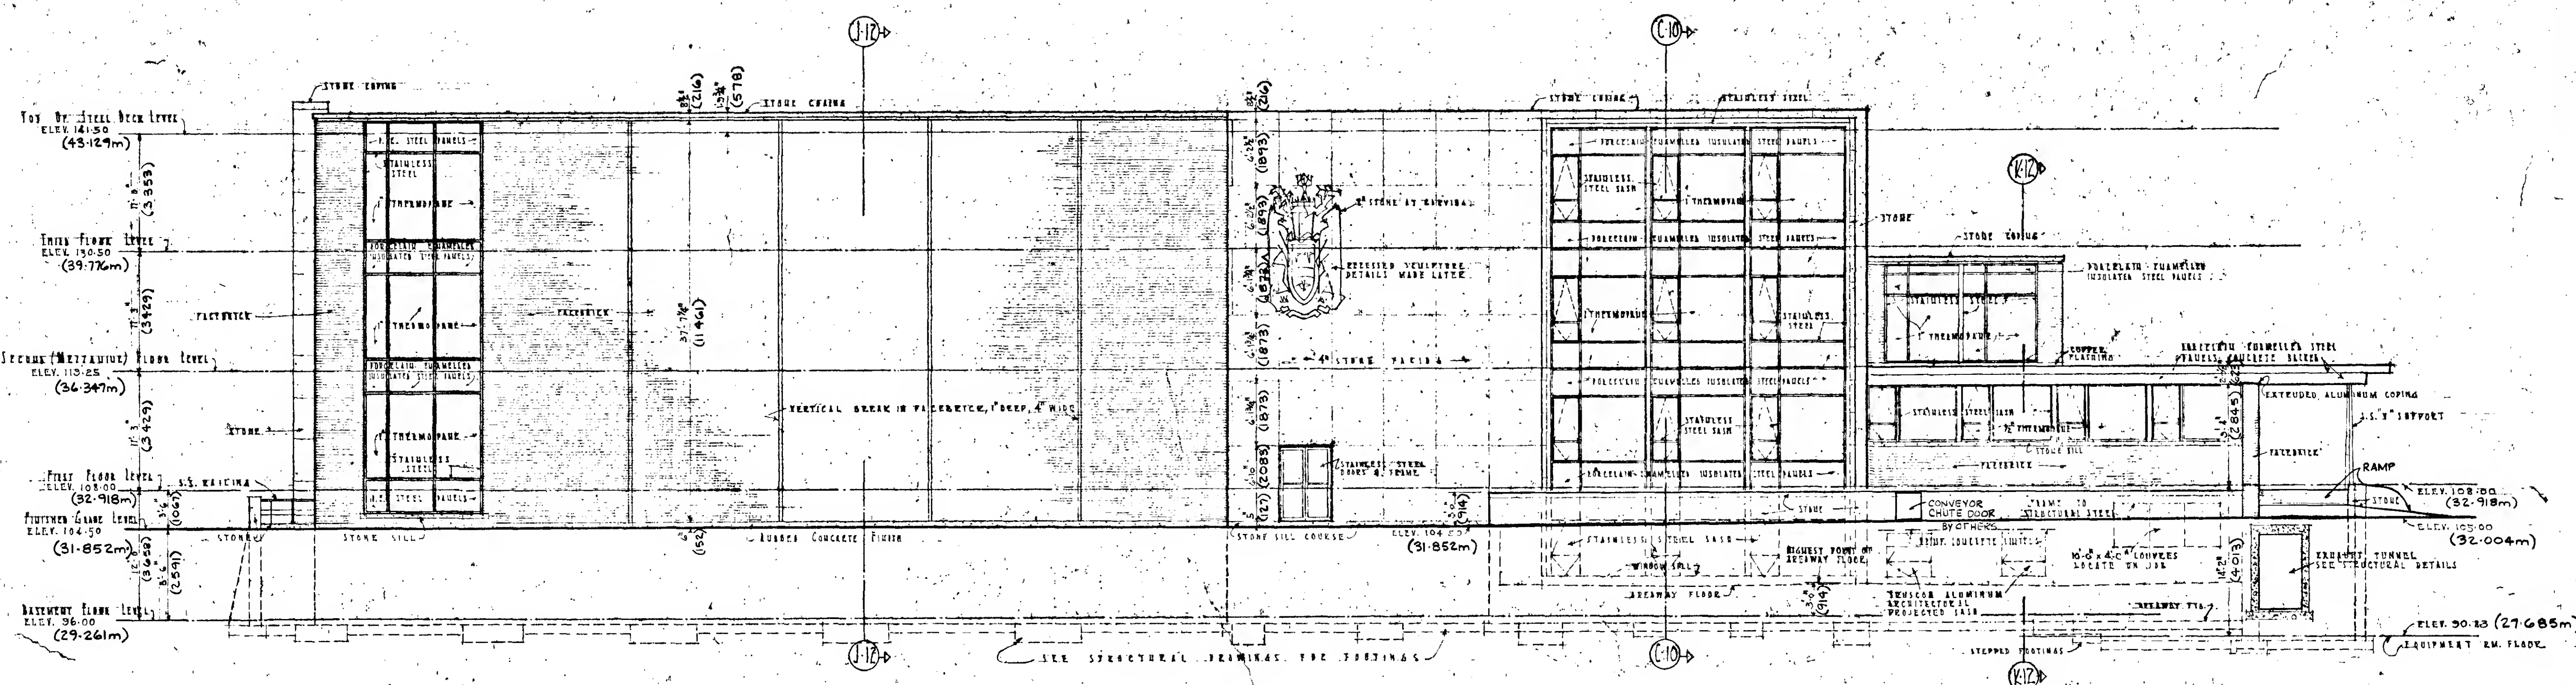

"METRIC" MEASUREMENTS SHOWN IN PARENTHESIS
ARE IN MILLIMETRES AND ARE EQUIVALENT
TO IMPERIAL MEASUREMENTS SHOWN

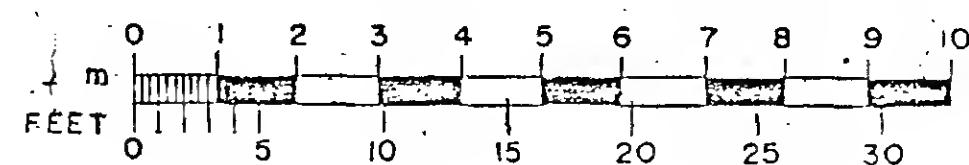

DATE	REVISIONS
MAR 31 1983	AS BUILT & METRIC CONVERSIONS

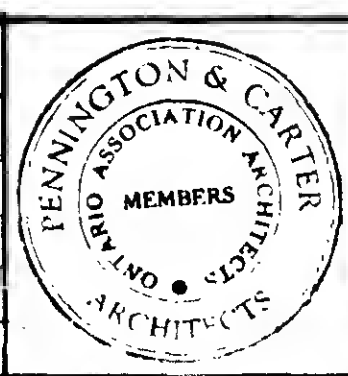

LIBRARY BUILDING
FOR
ASSUMPTION UNIVERSITY OF WINNIPEG
ARCHITECTS & ENGINEERS
WINNIPEG, MANITOBA, CANADA

JOB NO.
1152